CORPS OF ENGINEERS

U.S. ARMY

725,000 722,000 719,000 716,000 713,000 710,000 707,000 704,000 701,000

3,328,000

3,325,000

3,322,000

3,319,000


EAST BATON ROUGE PARISH

WEST BATON ROUGE PARISH

Sheet 2

National Oceanic and Atmospheric Administration (NOAA)

VICINITY MAP

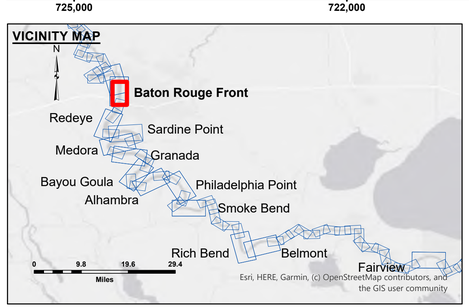

LEGEND

- Federal Navigation Channel
- Federal Navigation Center Line
- As-built Pipeline/Cable
- Unconfirmed Pipeline/Cable
- Project Depth Contour
- Cable Area
- Placement Area
- Anchorage Area
- Obstruction Point
- Wrecks-Submerged
- Borrow Area
- Shoalest Sounding**
- Beacon, General
- Red Navigation Buoy
- Green Navigation Buoy
- 0' and above
- 0' to -5'
- -5' to -10'
- -10' to -20'
- -20' to -30'
- -30' to -35'
- -35' to -40'
- -40' to 45'
- -45' and below

N W E S

Feet

0 500 1,000 1,500 2,000 2,500

LWRP:	2.6
Gage Reading:	BR:7.6 D:4.6 USED:7.7 NAVD88
Sea Conditions:	0-1FT
Vessel Name:	VALENTOUR
Survey Type:	CS
Sounding Frequency***:	HIGH

NOTES:

Horizontal Coordinate System:
North American Datum of 1983 (NAD83), projected to the State Plane Coordinate System (SPCS), Louisiana South Zone. Distance units in U.S. Survey Feet.

Vertical Datum:
Soundings are shown in feet and indicate depths below Low Water Reference Plane 2007 (NAVD).

Distances on the Mississippi River, above and below Head of Passes are shown at 1 mile intervals.

The location of navigation aids are base on and provided by the U.S. Coast Guard and USACE crew.

2021 Aerial Photography data source: NAIP, USDA-FSA-APFO Aerial Photography Field Office.

Reference is N.O.A.A. Navigation Chart No. 11370.

** Shoalest Sounding per Quarter per Reach.

*** High frequency (200 kHz) survey data represents the first signal return at a sounding location and will include suspended solids, known as "fluff", if present. Low frequency (20 kHz) survey data normally penetrates through this "fluff" layer to depict elevations of consolidated bottom material. Low frequency accuracies may vary depending on channel conditions and fathometer settings.

US Army Corps of Engineers
District: CEMVN

DISCLAIMER
Access Constraints: The United States Government furnishes this data and makes no warranty, expressed or implied, as to its accuracy, completeness, understanding that the US Government makes no warranties, expressed, or implied concerning the accuracy, completeness, reliability, or suitability of this data for any purpose. Any use of this information and the data furnished. The United States shall be under no liability whatsoever to any individual or group entity for any loss, damage, claim, cost, or expense incurred or arising out of reliance upon the information or data furnished or made thereof. These data belong to the Government. Therefore the recipient fully agrees not to represent these data to anyone as other than Government data. It is unlawful to misrepresent in any way these data to others without also transferring this Disclaimer.

The information depicted on this map represents the results of a survey conducted on the date indicated and can only be considered to represent the general condition existing at the time.

Distribution Liability: The data represents the results of data collection and analysis performed for government business activity and indicates the general existing conditions. As such, it is only valid for its intended use, content, time and accuracy of the application of the data for other than its intended purpose.

Data Constraints: Hydrographic survey data is subject to change due to environmental processes that occur between the survey activity and natural shoaling and scouring processes. The U.S. Government makes no warranties, expressed or implied, as to the hydrographical conditions which develop after the date of publication. This data is intended for U.S. Army Corps of Engineers' internal use. Reuse is restricted and for any other purpose.

U.S. ARMY CORPPS OF ENGINEERS
NEW ORLEANS DISTRICT

Surveyed By: FREMIN/CHAMPINE	Submitted:	Recommended:	Approved:
Plotted By: JH		Chief, Survey Section	Chief, Waterways Maintenance Section
Checked By: JH			

MISSISSIPPI RIVER - B.R. TO GULF
BATON ROUGE FRONT CROSSING
MD_01_BRF_20261102_CS
02 November 2026

Sheet Reference Number
1 **of** 97

Revison Number:
5.26.07.27-5.26.07.27