
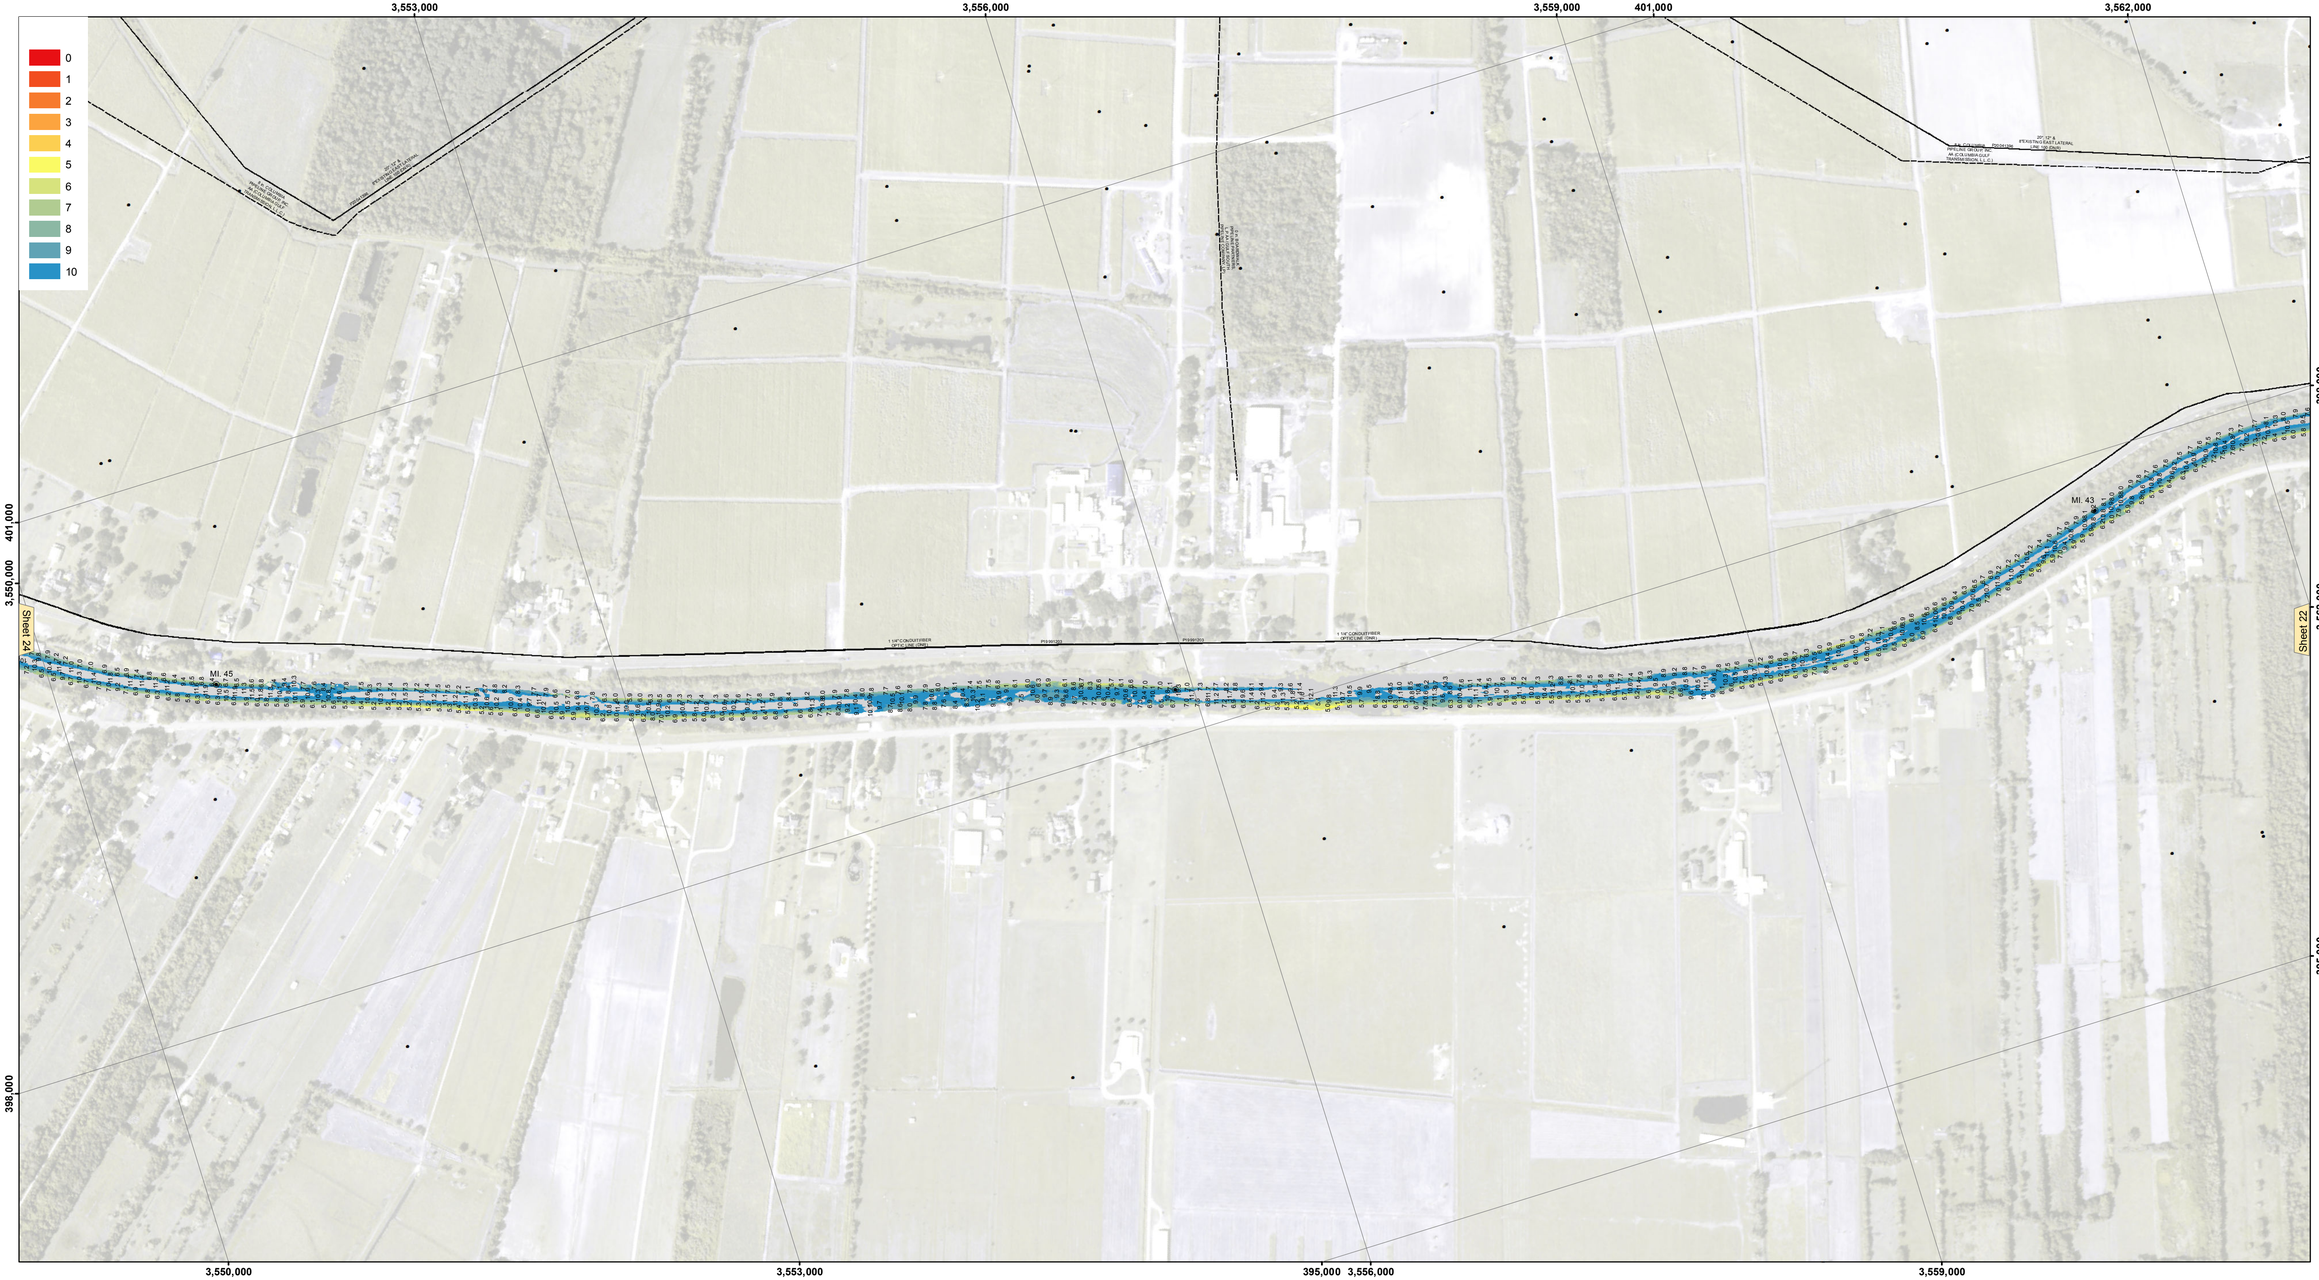


VICINITY MAP

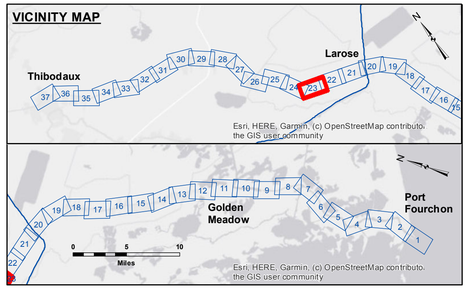

LEGEND

- Federal Navigation Channel
- Federal Navigation Center Line
- As-built Pipeline/Cable
- Unconfirmed Pipeline/Cable
- Project Depth Contour
- Cable Area
- Placement Area
- Anchorage Area
- Obstruction Point
- Wrecks-Submerged
- Borrow Area
- Shoalest Sounding**
- Beacon, General
- Red Navigation Buoy
- Green Navigation Buoy

Gage Reading:	NAVD
Sea Conditions:	CALM
Vessel Name:	DON JON
Survey Type:	CONDITION
Sounding Frequency***:	HIGH

Feet
0 500 1,000 1,500 2,000

NOTES:

Horizontal Coordinate System:
North American Datum of 1983 (NAD83), projected to the State Plane Coordinate System (SPCS), Louisiana South Zone. Distance units in U.S. Survey Feet.

Vertical Datum:
Soundings are shown in feet and indicate depths below Mean Low Gulf Datum (MLG).

Distances on the Bayou Lafourche are shown at 1 mile intervals.

The location of navigation aids are base on and provided by the U.S. Coast Guard and USACE survey crews.

2017 Aerial Photography data source: NAIP, 1998 DOQQ shown in transparent green.

Reference is N.O.A.A. Navigation Chart No. 11365 and 11346.

** Shoalest Sounding per Quarter per Reach.

*** High frequency (200 kHz) survey data represents the first signal return at a sounding location and will include suspended solids, known as "fluff", if present. Low frequency (20 kHz) survey data normally penetrates through this "fluff" layer to depict elevations of consolidated bottom material. Low frequency accuracies may vary depending on channel conditions and fathometer settings.

US Army Corps of Engineers
District: CEMVN

DISCLAIMER
Access Constraints: The United States Government furnishes this map and the data contained therein to the user on the understanding that the US Government makes no warranties, expressed, or implied concerning the accuracy, completeness, reliability, or suitability of this information for any purpose. The information and the data furnished. The United States shall be under no liability whatsoever to any individual or party for any action made thereof. These data belong to the Government. Therefore the recipient fully agrees not to represent these data to anyone as other than data received from the Government. The recipient shall not alter these data to others without also transferring this Disclaimer.

Distribution Liability: The data represents the results of data collection efforts conducted by the U.S. Army Corps of Engineers activity and indicates the general existing conditions. As such it is only valid for its intended use, content, time and accuracy of the application of the data for other than its intended purpose.

Data Constraints: Hydrographic survey data is subject to change due to continuous environmental processes such as shoaling activity and natural shoaling and scouring processes. The U. S. Army Corps of Engineers does not warrant the survey data to be the hydrographical conditions which it portrays after the date of publication. This data is intended for U. S. Army Corps of Engineers' internal use. Present environmental conditions may greatly vary.

U.S. ARMY CORPS OF ENGINEERS
NEW ORLEANS DISTRICT

Surveyed By: DON_JON		
Plotted By: AO		
Checked By: AO		
Submitted:	Recommended: Chief, Survey Section	Approved: Chief, Waterways Maintenance Section

BAYOU LAFOURCHE
BAYOU LAFOURCHE
LF_23_UPR_20211003_CS_POSTIDA
03 October 2021

Sheet Reference Number
23 of 37

Revison Number:
4.2-20200420