
U.S. ARMY CORPS OF ENGINEERS

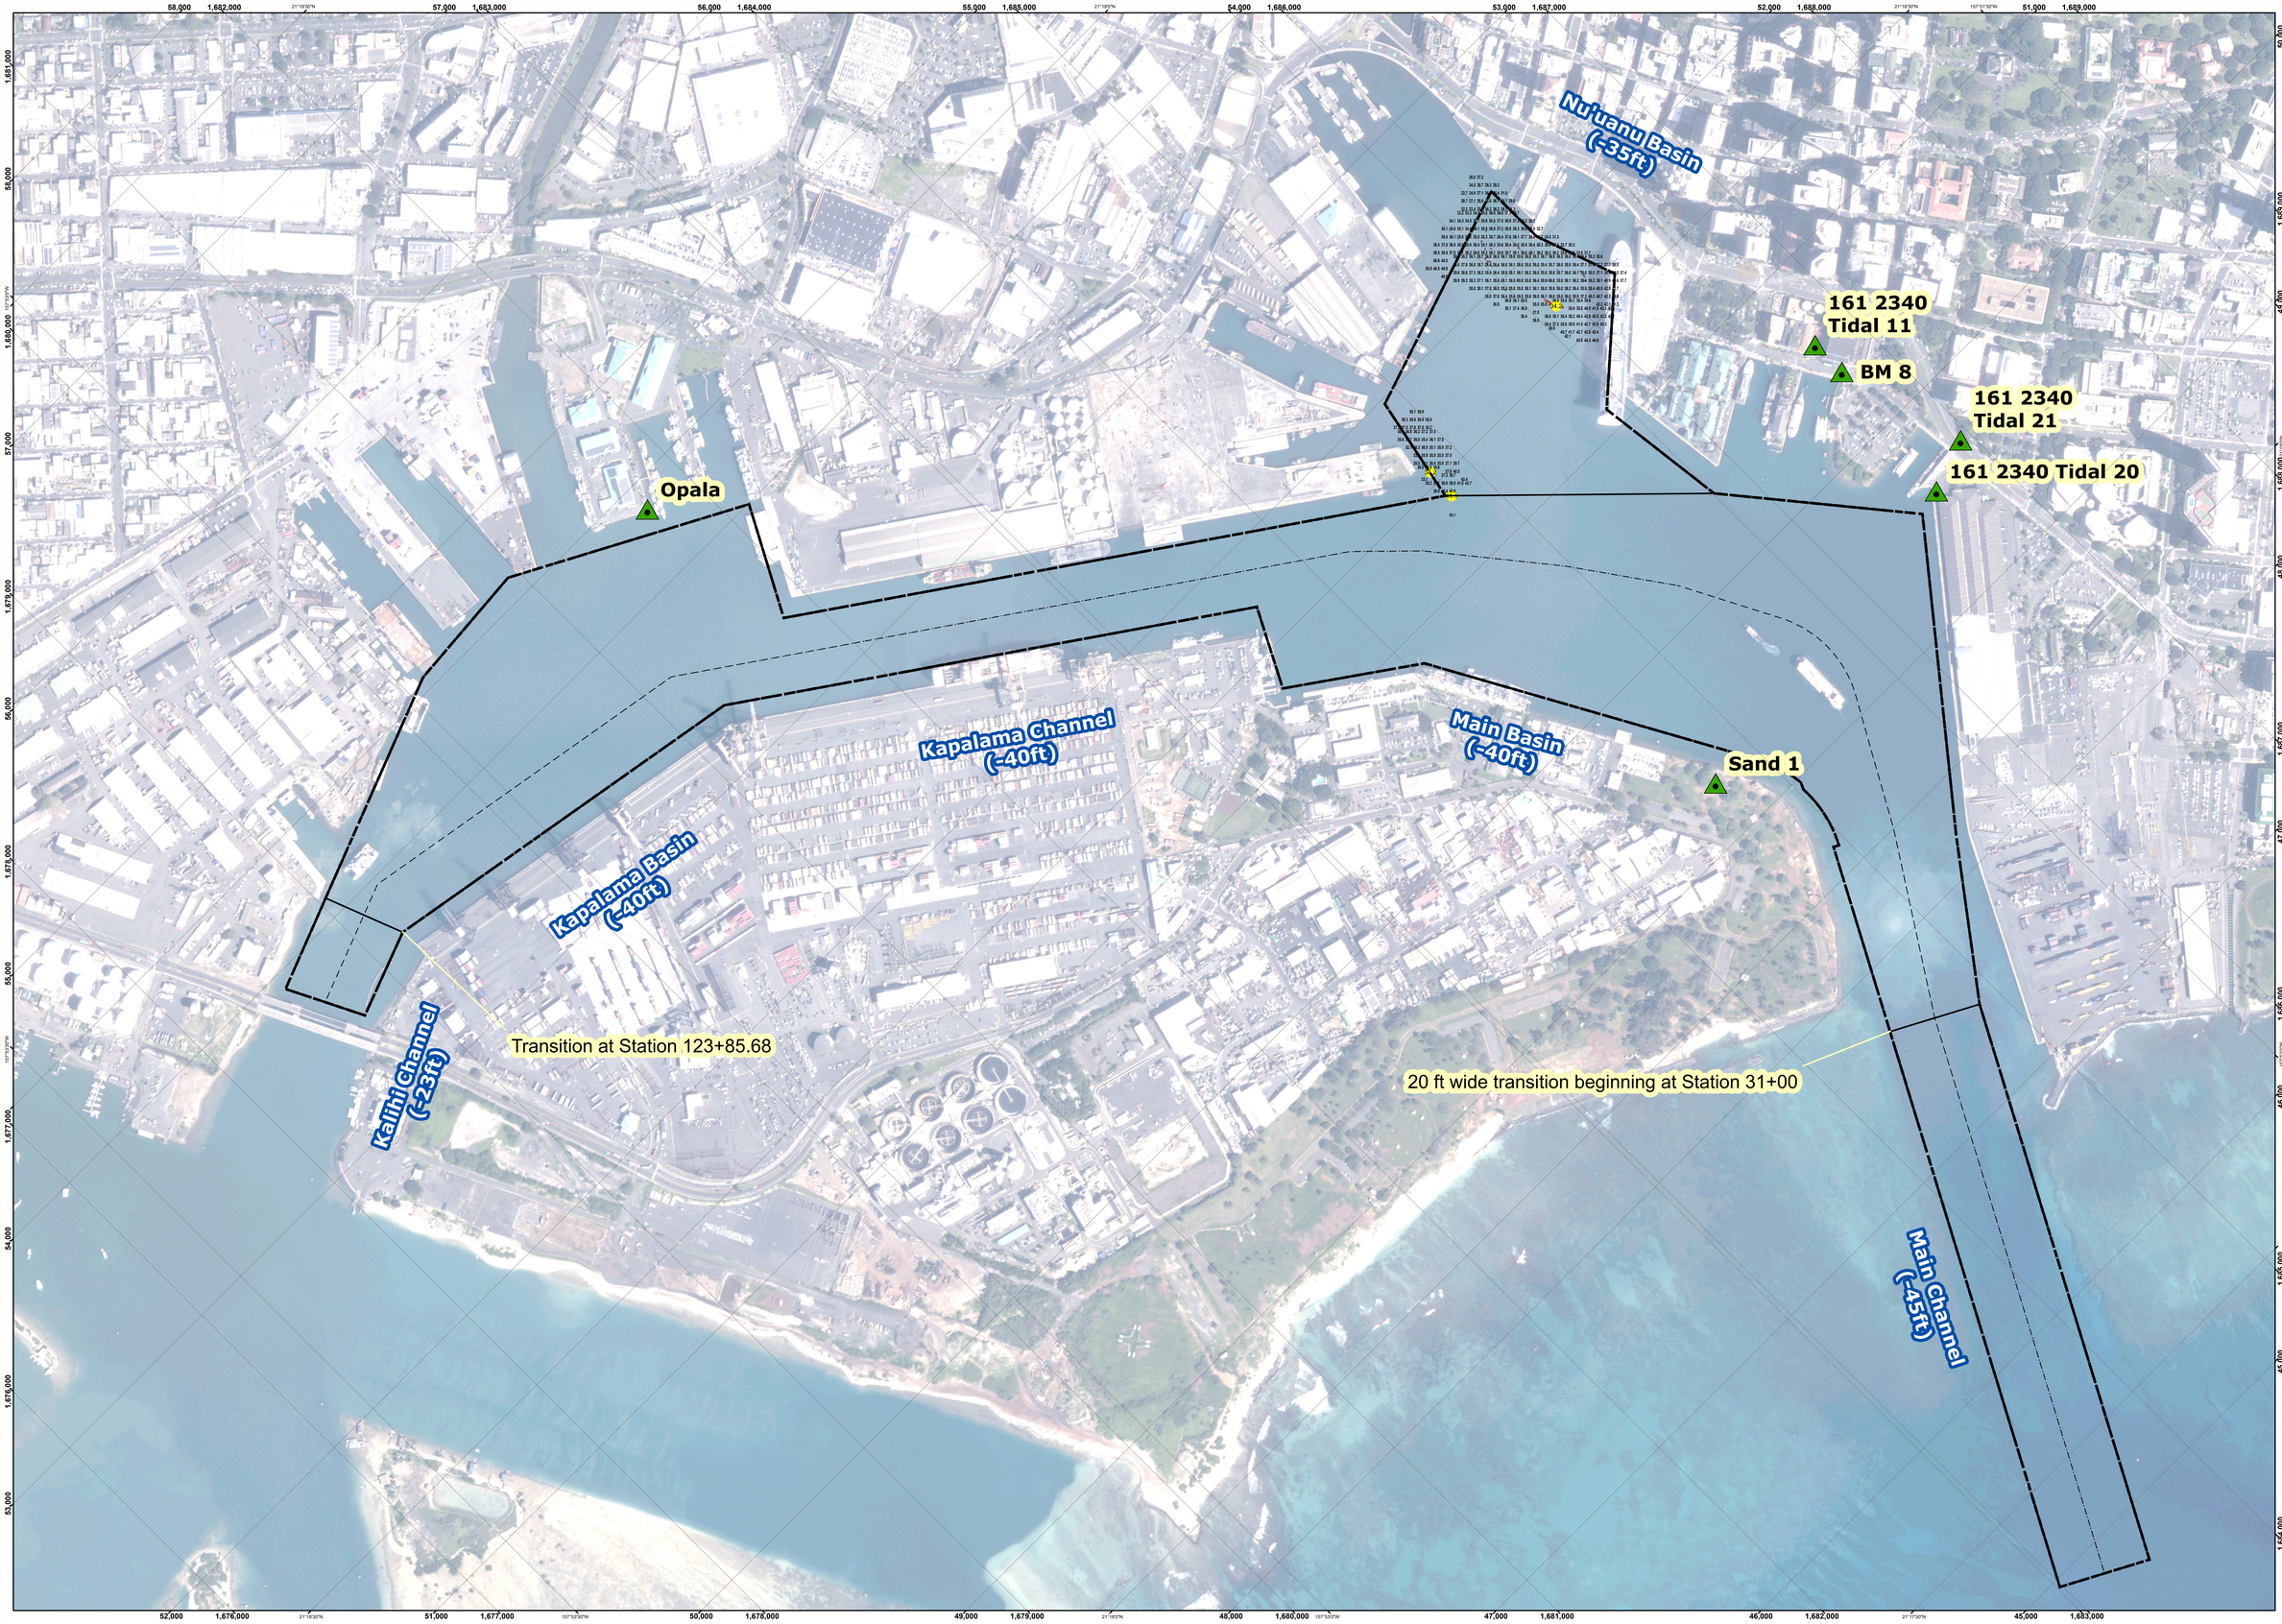

US Army Corps of Engineers
Honolulu District

Distribution Liability. The data represents the results of data collection/compilation by a specific US Army Corps of Engineers project for a specific project purpose and under specific conditions. As-built data is compiled from various sources and is not guaranteed to be accurate or complete. No warranties, expressed or implied, are provided for the data or its use or interpretation. The USACE has performed certain data collection and processing activities to meet its own project purposes and needs. The USACE makes this data available as a courtesy to the public and other agencies. The user is responsible for the manner in which they use this data. The USACE shall not be liable for any damages arising from the user's use of the data, or any reliance or decisions made by the user based on the data. The user shall not represent to any third party that the USACE has approved of the user's use of 